


1649 PANDOSY

PANDOSY ST.

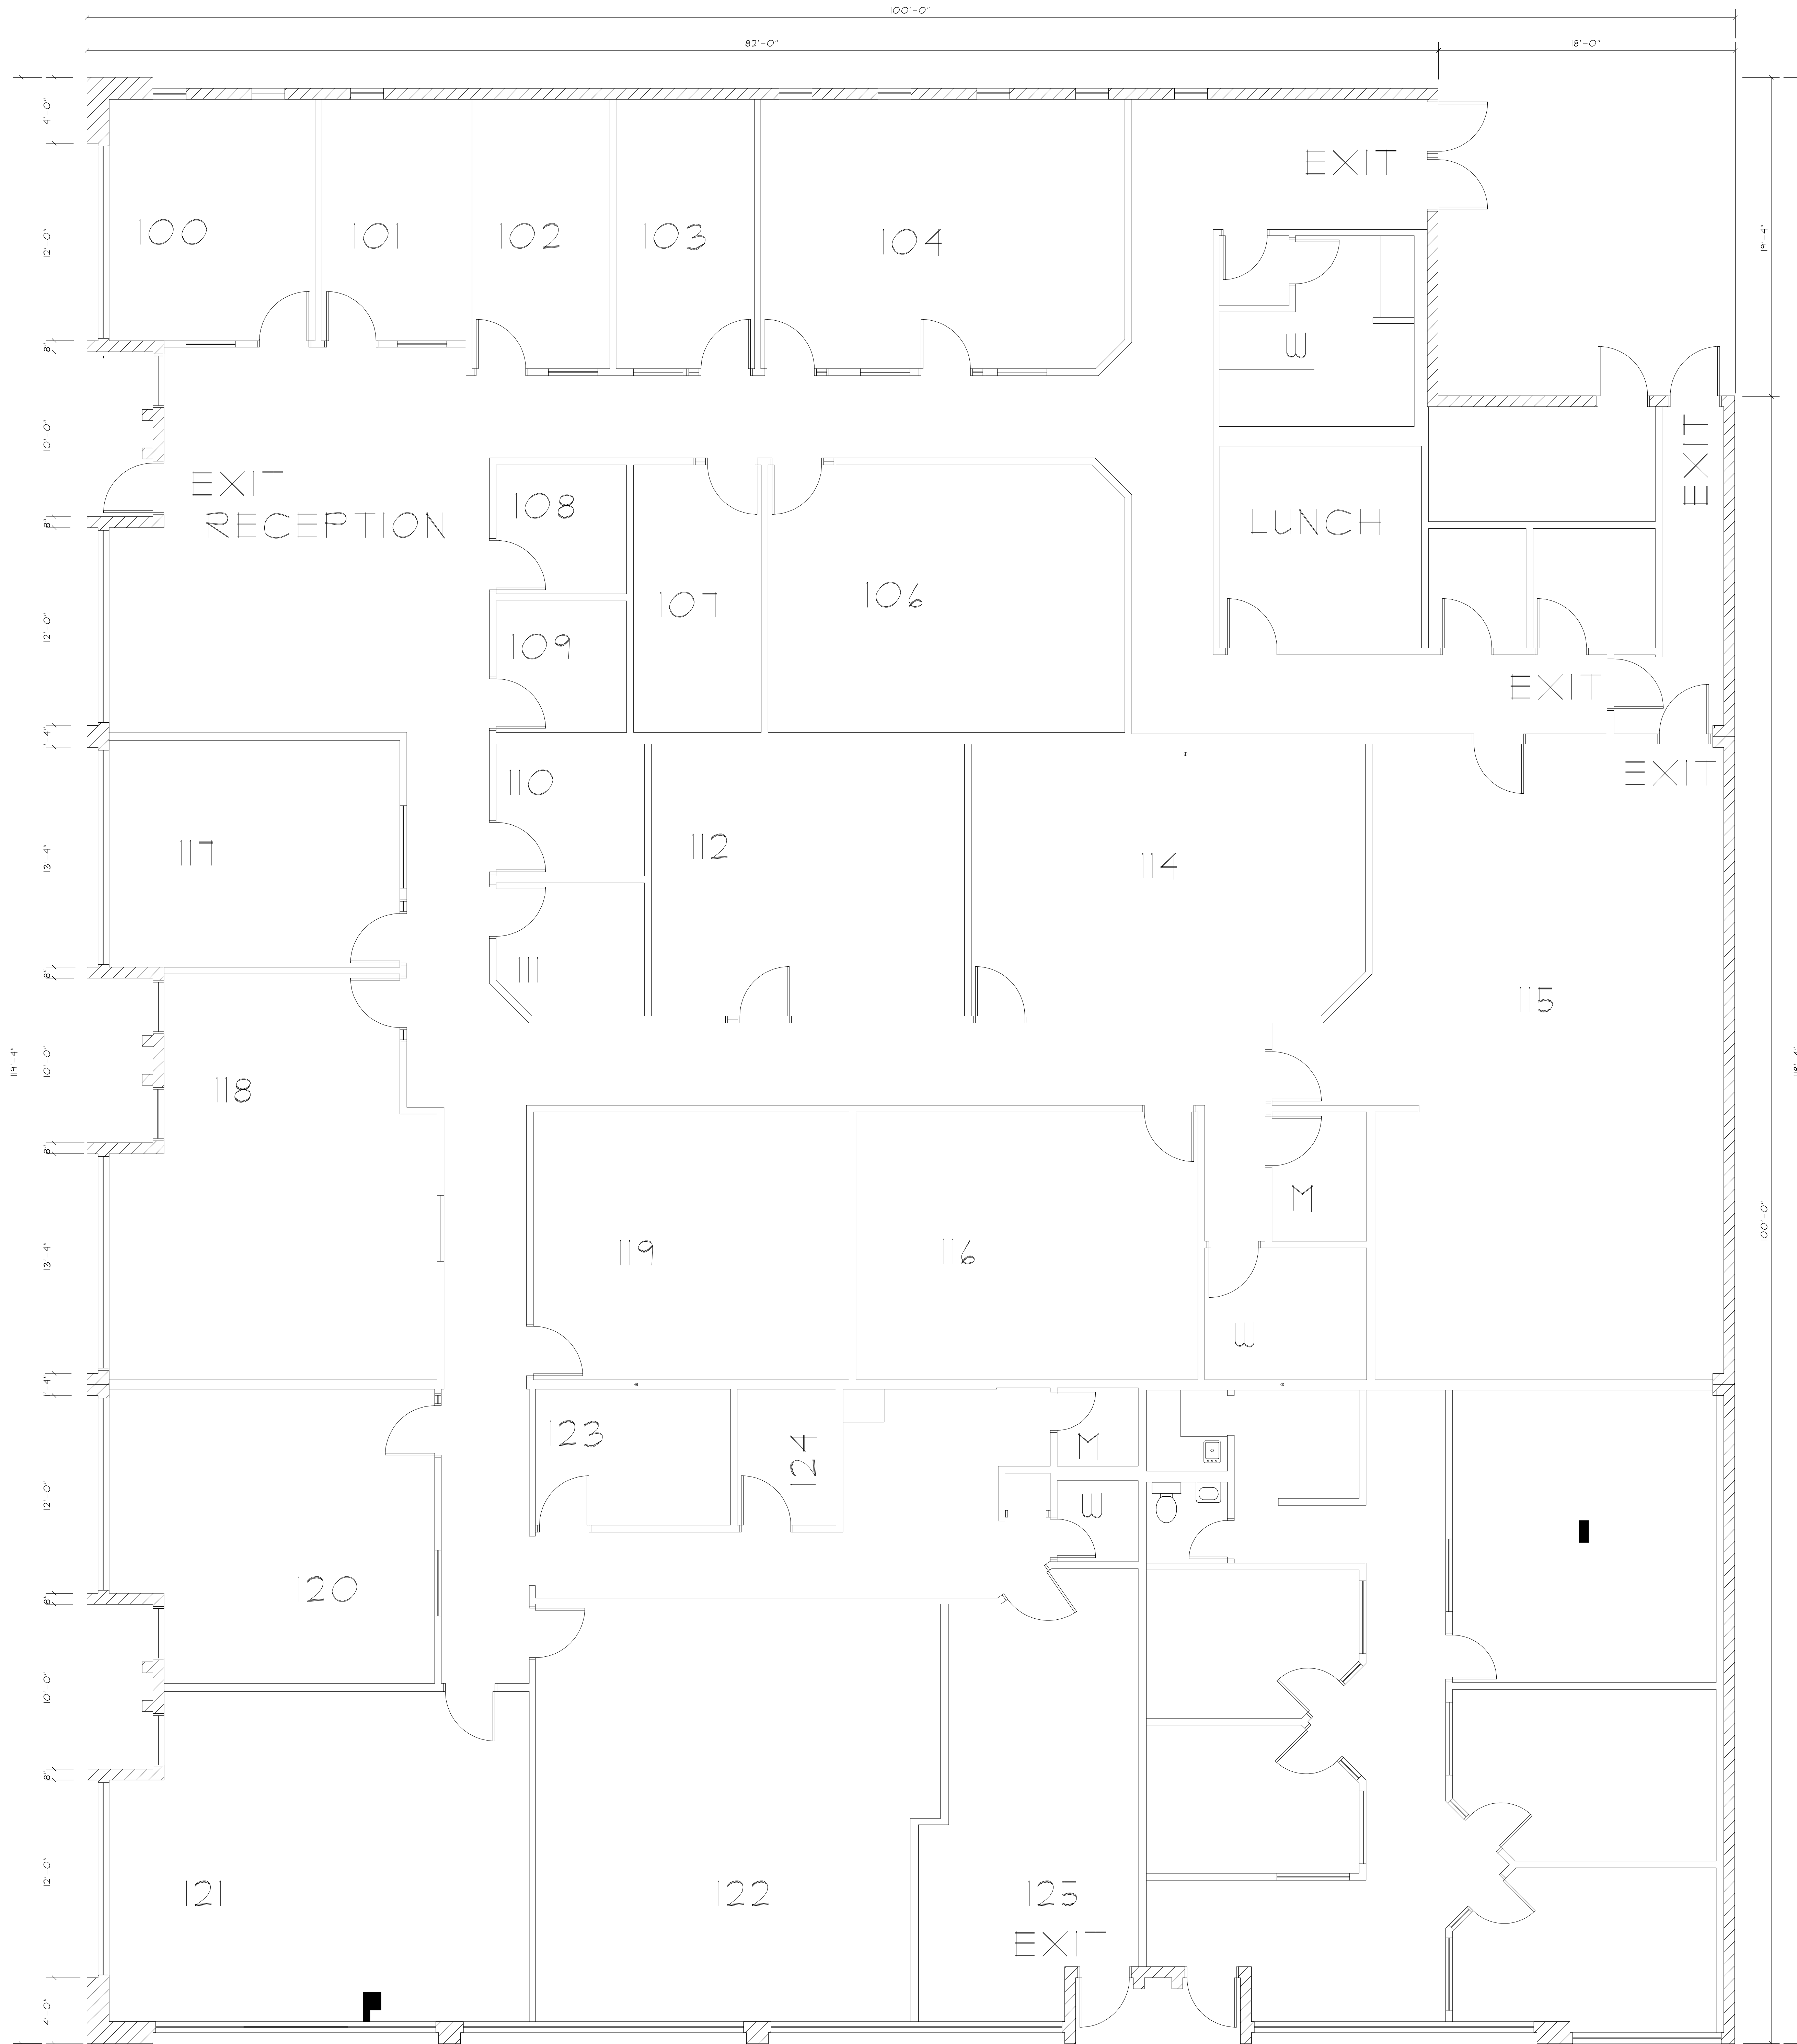

LEON AVE

11284 SQ.FT.

SCALE: 1/4" = 1'-0"  
UNLESS INDICATED

VANCOUVER  
CAREER COLLEGE

REVISIONS		
DATE	REV.	DESCRIPTION
10/11		START
10/23		MEASURING
10/24		ADDITIONAL MEASURING

THIS PRINT IS ISSUED SUBJECT TO RETURN UPON DEMAND AND UPON THE EXPRESS CONDITION THAT IT IS NOT TO BE USED IN ANY WAY DIFFERENTIAL TO OUR INTERESTS. IT IS NOT TO BE REPRODUCED IN ANY FORM WHATSOEVER WITHOUT THE CONSENT IN WRITING OF THE ARCHITECT / ENGINEER / DESIGNER OR THEIR AGENTS. DO NOT SCALE THIS DRAWING.

BC AS BUILT



DATE  
COPYRIGHT OF:  
RSM DRAFTING SERVICES LTD.

CUSTOMER:  
Vancouver Career College  
1649 PANDOSY ST.  
KELOWNA, B.C. V1Y 1P6

PROJECT  
JOB NO.  
RSM 12-033

REVISION:  
DRAWN BY: RSM  
DRAWING DATE: Oct. 18, 2012  
FILE NAME: NOTES  
CHK. BY: RSM